

FURNESS, S. B. CO. No. 343.

STEAM TANKER

"EMPIRE LYTTON"

PROFILE & DECK PLANS

As Built.

MIDDLESBROUGH REPORT.

No 17323

343

RETAIN



© 2020


Lloyd's Register
Foundation

W1195-0055

341-2-3-4 No 343 - PROFILE & DECK PLAN -

DIMENSIONS LENGTH BP 475'0" BREADTH M^o 68'0" DEPTH M^o 36'0"

SCALE 1/8" = 1'00"

 

FURNESS S.B. CO LTD 343.

STEAM TANKER.

"EMPIRE LYTON"

MIDSHIP SECTION

AS BUILT.

MIDDLESBROUGH

REPORT.

NO. 17323.

RETAIN



© 2020

Lloyd's Register
Foundation

W1195-0056

STERN FRAME
V RUDDER

(3)

FURNESS SBCOL

341.234-49.50

S.S. "Empire Dickens"

MDB. RPT. No. 17239

S.S. Empire Norseman

MDB. RPT. No. 17276

S.S. Empire Lyttora

MDB. RPT. No. 17323

S.S. Empire Grenadier

MDB. RPT. No. 17347



S.S. Empire Nugget

MDB. RPT. No. 17375

S.S. Empire Cobbett.

MDB. RPT. No. 17401 'San Wilfrido'

RECORDS DEPT.
LONDON.

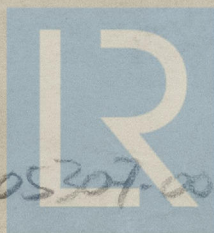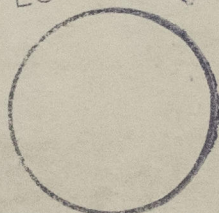

© 2021

Lloyd's Register
Foundation

005307-005310-0001

© 2021
Lloyd's Register
Foundation
0053.07-005310-0001